



# BARDA III FLAT TOP BARGE

## Characteristics

Vessel Type	Flat Top Barge
Official Number	6230
Flag	Nigeria
Port of Registration	Lagos
Class	ABS (Class No. 7705223)
Class Notations	+A1, Barge
Builder	MC. Dermott Inc.
Built	1977

## Dimensions

GRT	1358
NRT	815
Length	60.96 M
Breadth	15.24 M
Depth	3.81 M
Summer Draught	2.476 M

## Capacity

Cargo capacity	2000 Tons
Deck Strength	10 Mtr.


## General Characteristics

Navigation Lights	Port Starboard and Stern
Stanchions	There Are Heavy Duty Stanchions 13Pcs on Each Port and Stbd. Side for Pipe Carriage Total Pcs




## Damas Oil & Marine Services Limited

IMO (ISM) Code Compliant  
 Km 17, PH/Aba Expressway, Port Harcourt, Rivers State - Nigeria  
 Tel No.: +234-07064070853 & 07064070854  
 FAX: +234-07064070856  
 Website: [www.damasgroupe.com](http://www.damasgroupe.com)  
 E-mail: [info@damasgroupe.com](mailto:info@damasgroupe.com)

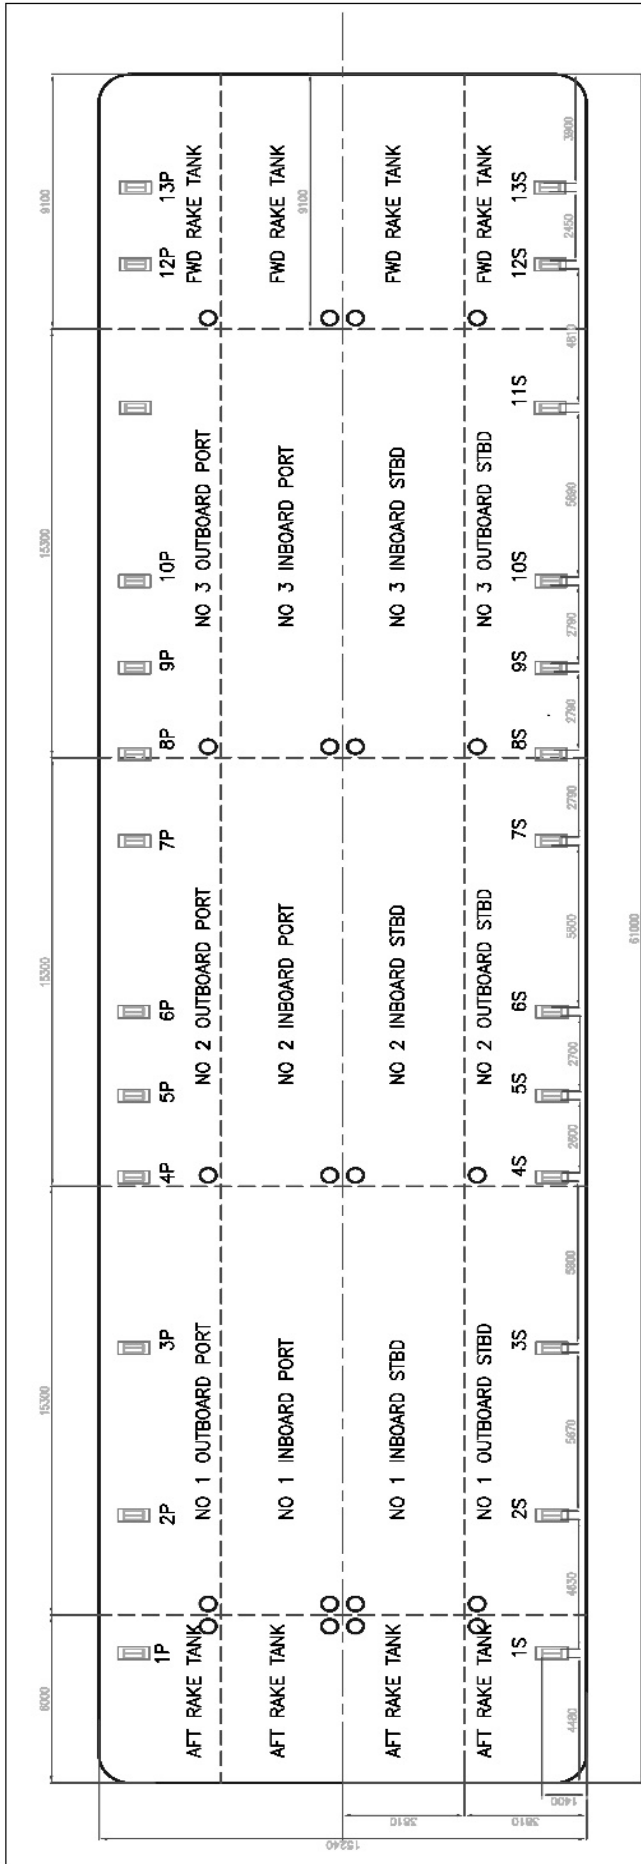


**PLAN VIEW**

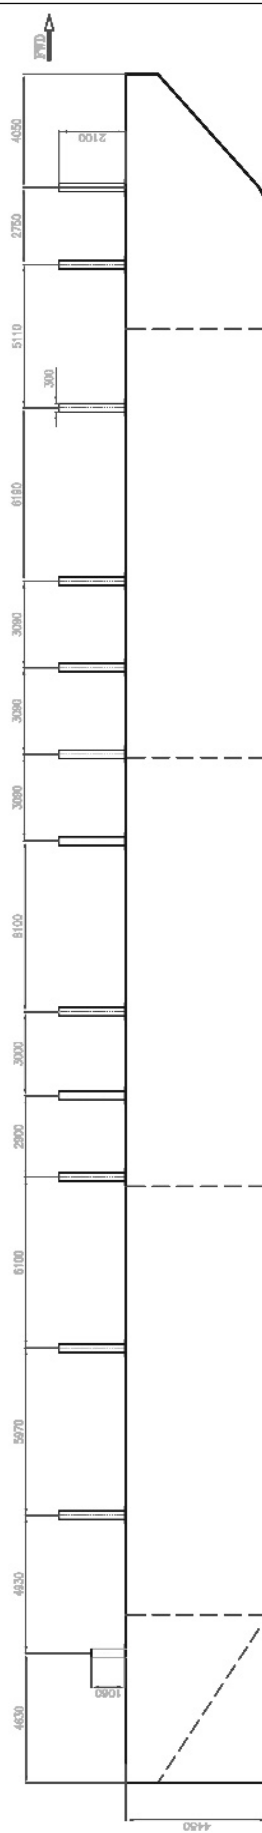

**PROFILE VIEW**

REV	ISSUED FOR APPROVAL	DESCRIPTION	AG	BY	DATE
0					11/05/2011

 <b>DAMAS OIL &amp; MARINE SERVICE LTD.</b> Km 17,4 Aca Expressway, PH, River State, Nigeria PO BOX 11802. Tel: +2347064070854		CLASS NO :
<b>GENERAL ARRANGEMENT</b> <b>CB BARDA III</b>		IMO NO :
DATE :	APPROVED BY :	DATE :
03 Oct. 12	AC	03 Oct. 12
DRAWN BY :	AS-BUILT MOD. BY :	DWG NO. :
AC	DIEPREYE	BDIII-001

